



# 17TH FLOOR

Partial Floor | Open Plan

5,684 SF

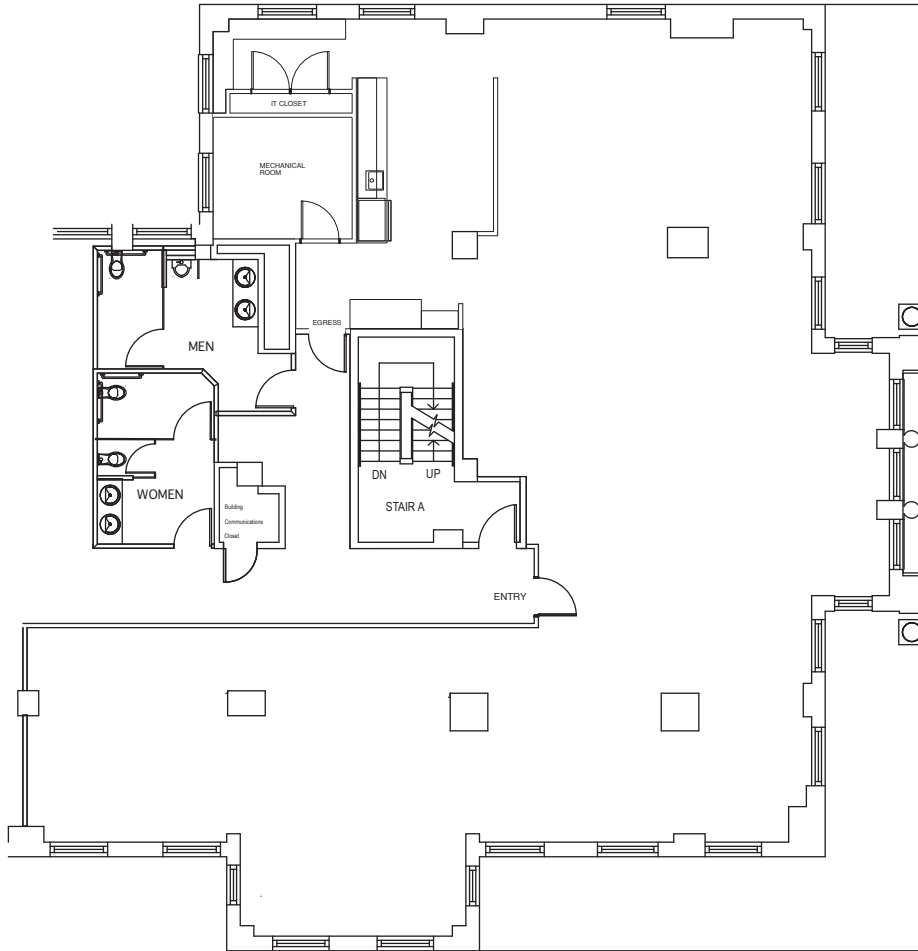

AS BUILT

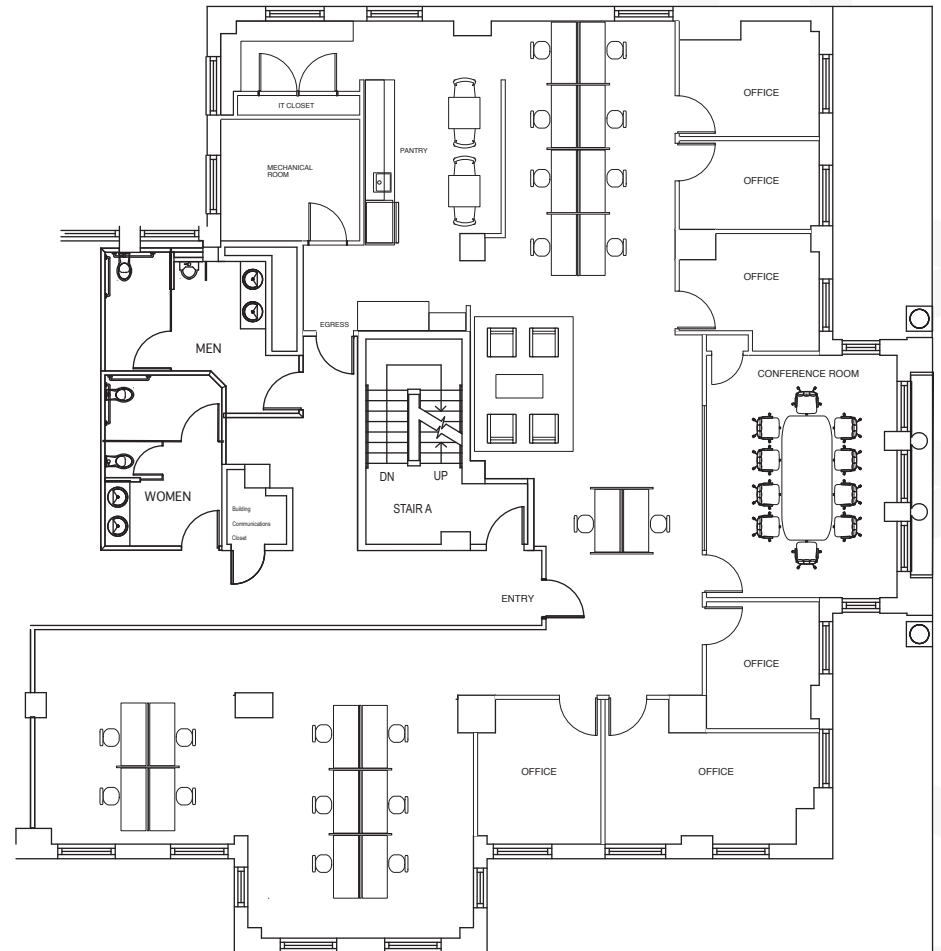

TEST FIT

57W57



# 17TH FLOOR

Partial Floor | Open Plan

5,684 SF



57W57

# 17TH FLOOR

Partial Floor | Open Plan

5,684 SF



57W57

Colliers