



17TH FLOOR

Partial Floor | Open Plan

5,684 SF

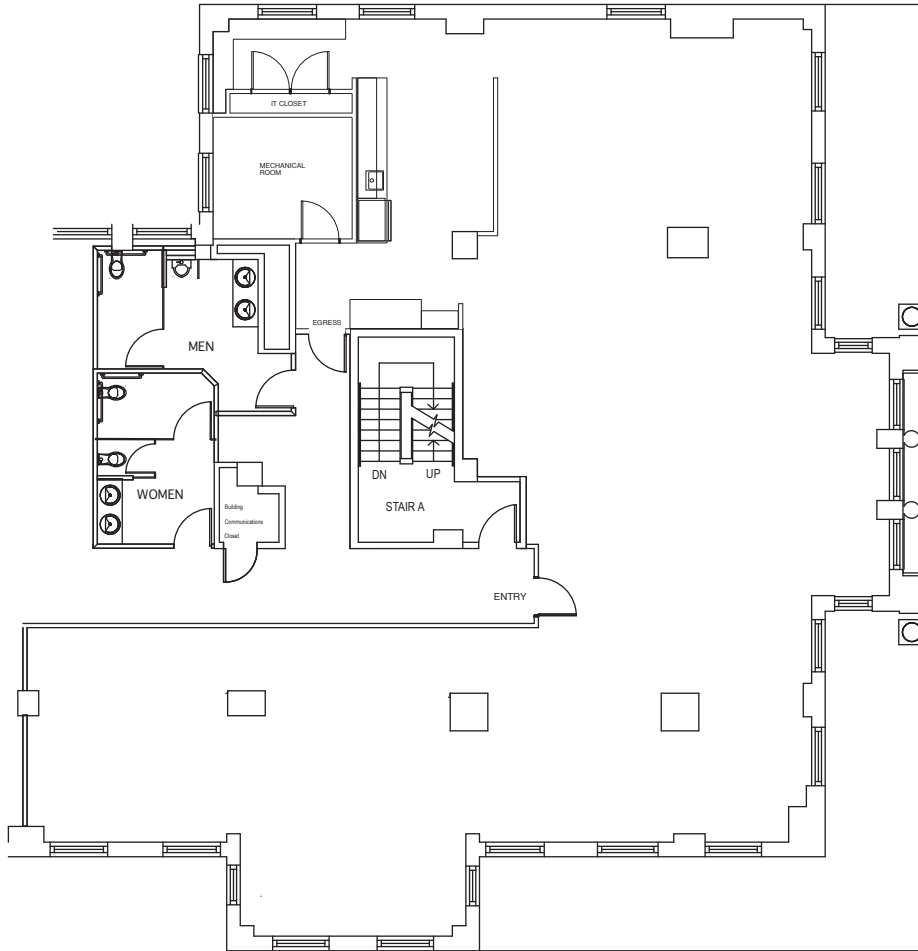

AS BUILT

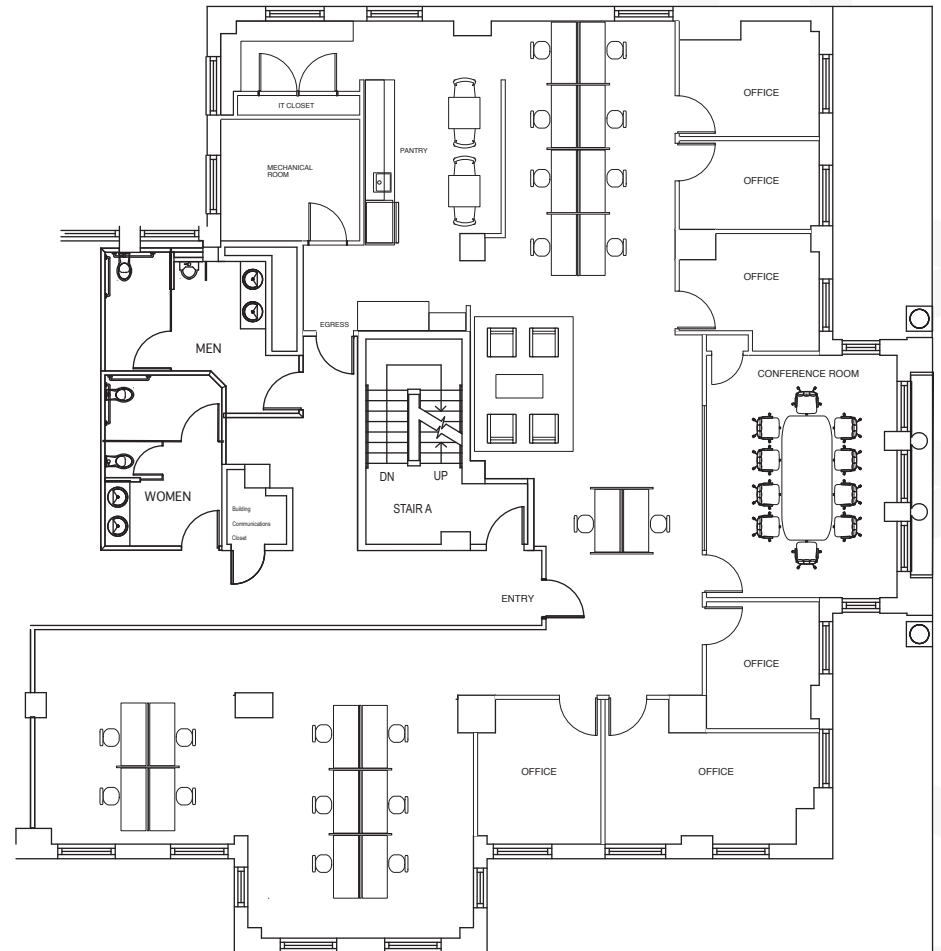

TEST FIT

57W57

17TH FLOOR

Partial Floor | Open Plan

5,684 SF




57W57

17TH FLOOR

Partial Floor | Open Plan

5,684 SF

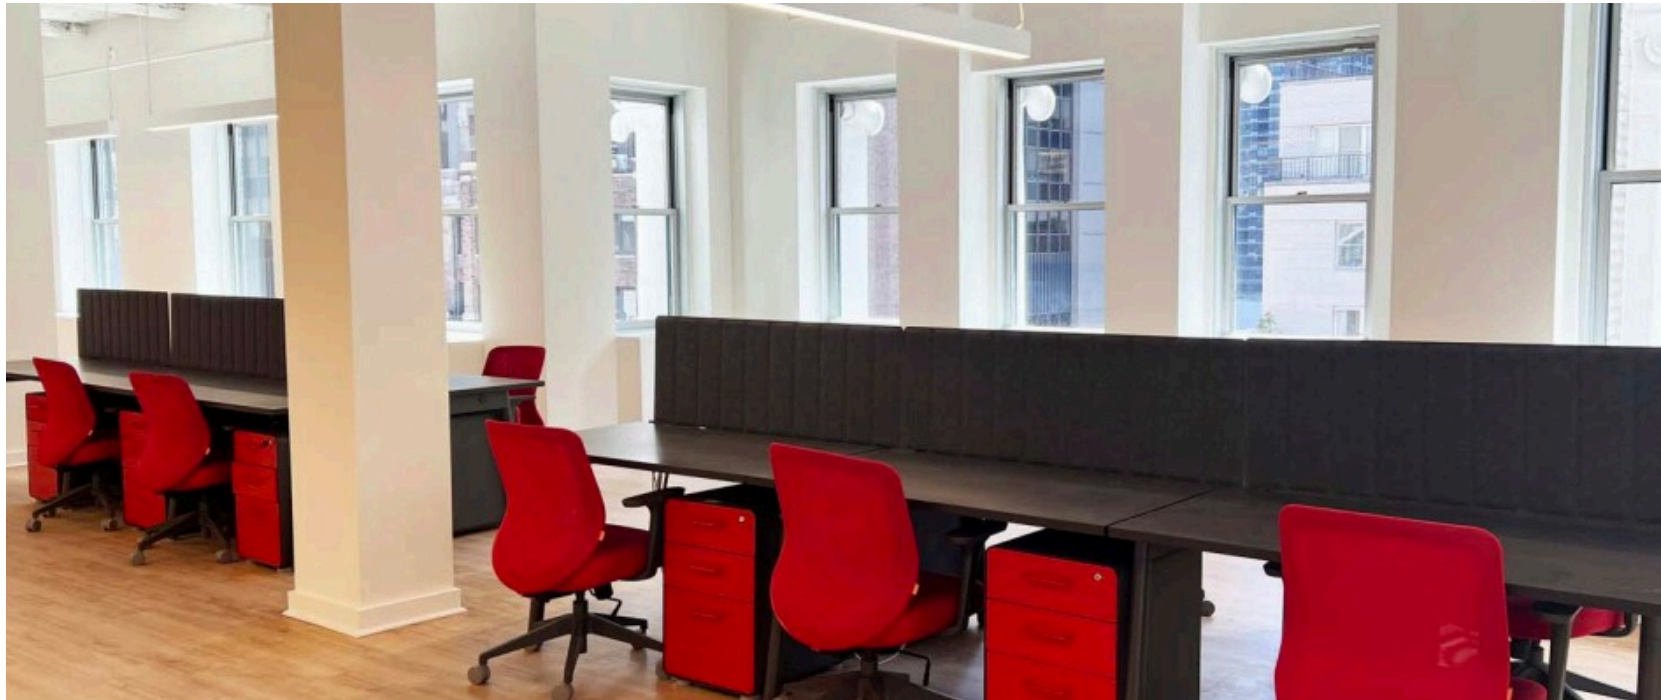

57W57

Colliers